MACON COUNTY PUBLIC HEALTH CENTER

Franklin, North Carolina 28734

SUBSURFACE SEWAGE SYSTEM OPERATIONS PERMIT - TYPES II-IV

☐ New Installation ☐ Addition to Existing System ☒ Partial Repair ☐ 100% Repair

☐ Single family dwelling(s) 1 # ☐ Multi-family dwelling ☐ Commercial (type) _____

Total # bedrooms 3 Daily Flow: (Gallons per day): 360

Property Owner: Terry Breedlove

Property Description: Lot # 1 Dowde Trace

Township Franklin Parcel ID Number _____ Map Number _____

Type of System High Capacity Chamber System Classification III

Septic Tank Size EXISTING Pump Tank Size _____ Trench Bottom Depth 30" LOW SIDE LTAR .45

Drinking Water Source: ☐ Individual Well/Spring ☐ Shared Well/Spring ☐ City ☐ Community

Future Repair Area Required ☐ Yes ☒ No Type of System for Future Repair _____

Date Improvements Permit/Authorization to construct issued 3-14-03 Permit No. _____

Installer Self Design Engineer _____ Project Number _____

Inspection Frequency: Health Dept. _____ Mgt. Entity _____ Mgt. Entity Reporting Frequency _____

Cautions or Comments: _____


The following checked items are on file and are part of this Operations Permit:

☒ Application ☒ Improvement Permit ☐ Survey/Plat Map ☐ Engineer's Drawing

☐ Soil Data Sheet ☒ Authorization To Construct ☐ Map (Other) ☐ Zoning Permit

☐ Other _____

DIAGRAM (Not to Scale)

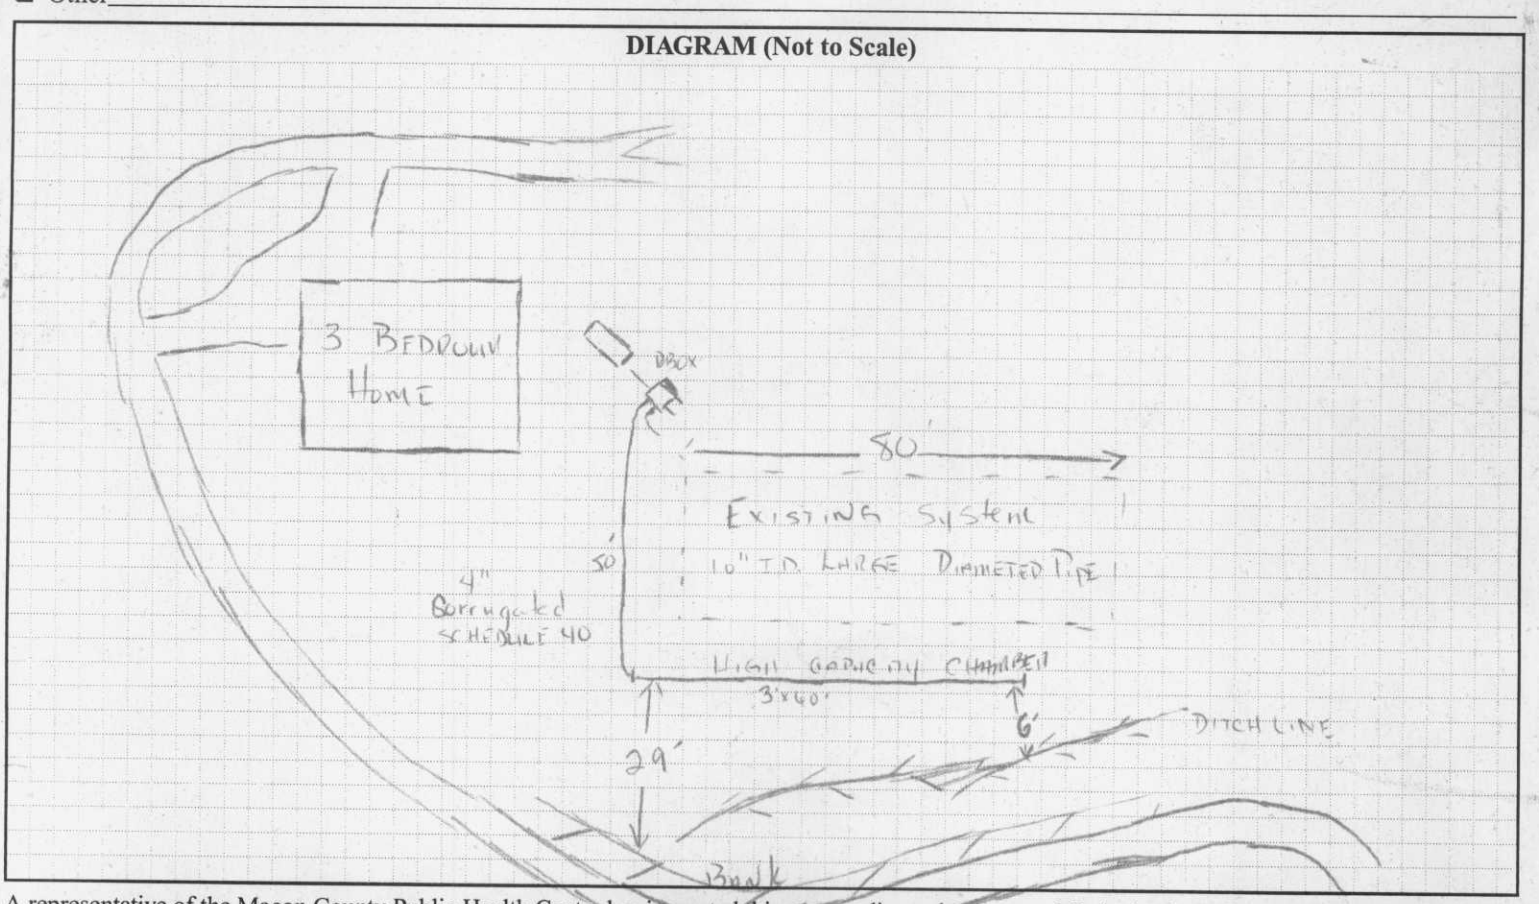

A representative of the Macon County Public Health Center has inspected this sewage disposal system and finds that it conforms to state guidelines. This permit is issued subject to all the provisions of the North Carolina Laws and Rules for Sewage Treatment and Disposal. **No person is permitted to make alterations to this system without the approval of an authorized Environmental Health Specialist.** This approval indicates that this system has been installed in compliance with the standards as set forth in the above regulations, but shall in no way be taken as a guarantee that the system will function satisfactorily for any given period of time. **The area designated as "repair area" is required for future use and must remain undisturbed.**

3-24-03
Date Inspected

for Environmental Health Specialist

White-Owners's Copy Yellow-Health Dept. Copy Pink-Building Inspection Dept. Copy