


4

The above signature indicates that I have read, understood and concur with all provisions and information as outlined on the back.

2091

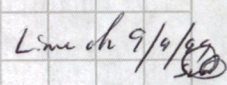

Chuk. D/any
& Tur in Tord